

1 2 3 4 5

YAZAKI PART NO.	MATING PART NO.	COLOR
7182-8720	7283-8720	NATURAL
7182-8720-30	7283-8720-30	BLACK
7182-8720-40	7283-8720-40	LIGHT GRAY

NOTES




1. APPLICABLE REAR HOLDER NO.: 7157-4601-80
2. APPLICABLE TERMINAL NO.: 7114-1680-02

3. ~~MATING PART NO.: 7283-8720-30~~

注 記

1. 適用リヤホルダ品番 : 7157-4601-80
2. 適用ターミナル品番 : 7114-1680-02

3. ~~適合相手品番 : 7283-8720-30~~

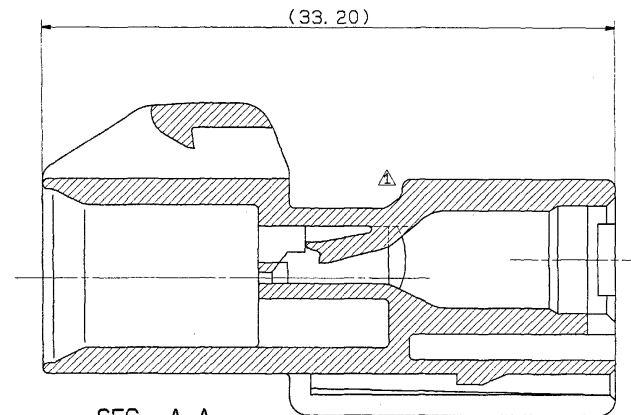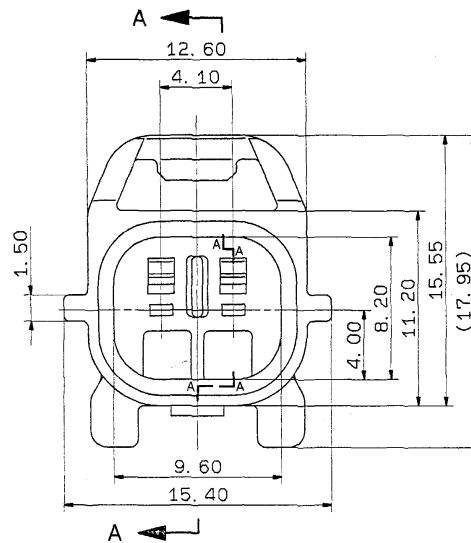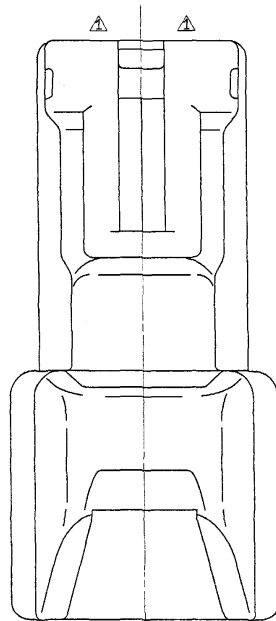

SEC. A-A

ISSUE MARK

LET	DATE	REVISION RECORD	NO.	CHKD
△	94.06.10	ADDED PART NO.	C94-L863	J. I
△	93.03.30	ADDED PART NO. ETC.	C93-6425	A. H
	90.09.25	NEW	C90-L993	S. I

GENERAL TOLERANCE									
10MAX	50MAX	100MAX	250MAX	2500VRI	ANGLE	ECCENT	DWG TYPE	DWG SOURCE	DWG DATE
A ±0.15	±0.2	±0.3	±0.5	±0.75	±30°	0.1	R	NEW	90.09.25
B ±0.2	±0.3	±0.55	±0.95	±1.4	±30°	0.1	APPROVED	CHECKED	CHECKED
③ ±0.3	±0.5	±0.8	±1.4	±2	±30°	0.15	DESIGN	DRAWN	94.06.13
SPECIFIED						MASS	94.06.15		

CUSTOMER			ISSUE MARK			
CUSTOMER PART NO.		CUSTOMER DWG NO.		MATL. SPEC.	PBT	TREAT. & FIN.
OFFICE		TRIAL PART NO.		NAME		
VENDOR		-----		SSD CONNECTOR 2P MALE		
VENDOR NO.		-----		HOUSING		
DWG TYPE	DWG SOURCE	DWG DATE	UNIT	SCL	ANGLE	PART NO.
R	NEW	90.09.25	mm	5/1	3	CH. CODE
APPROVED		CHECKED	CHECKED	DESIGN	DRAWN	DWG NO.
KANAKO		KANAKO		SAMUKAWA		7182-8720-30:R
98.06.25		94.06.14	94.06.13	89.11.01	94.06.10	YAZAKI CORPORATION

1

2

3

4

5