© 2023 TE Connectivity. All Rights Reserved.

REVISIONS					
P	LTR	DESCRIPTION	DATE	DWN	APVD
	A1	REVISED PER ECR-23-XXXXX	30JAN2023	RK	MT

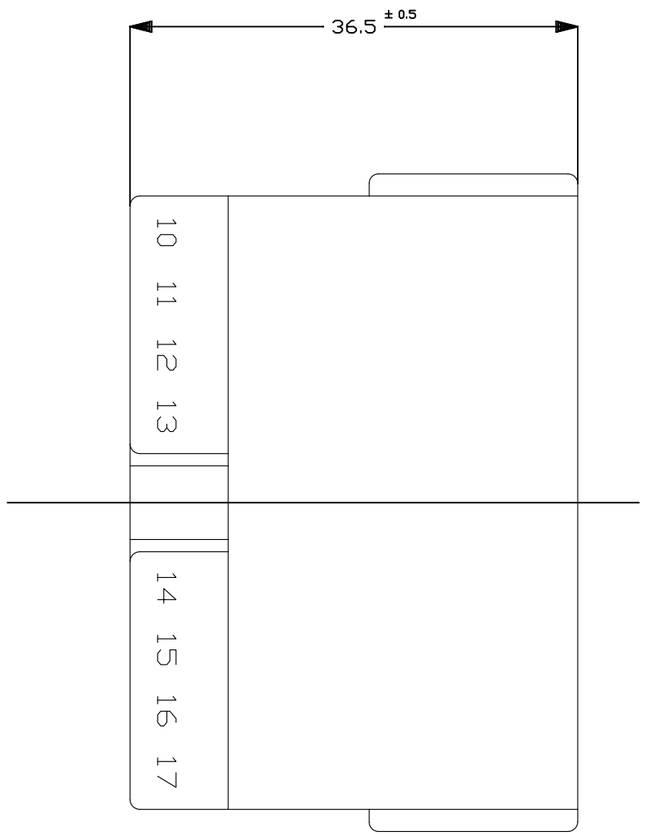

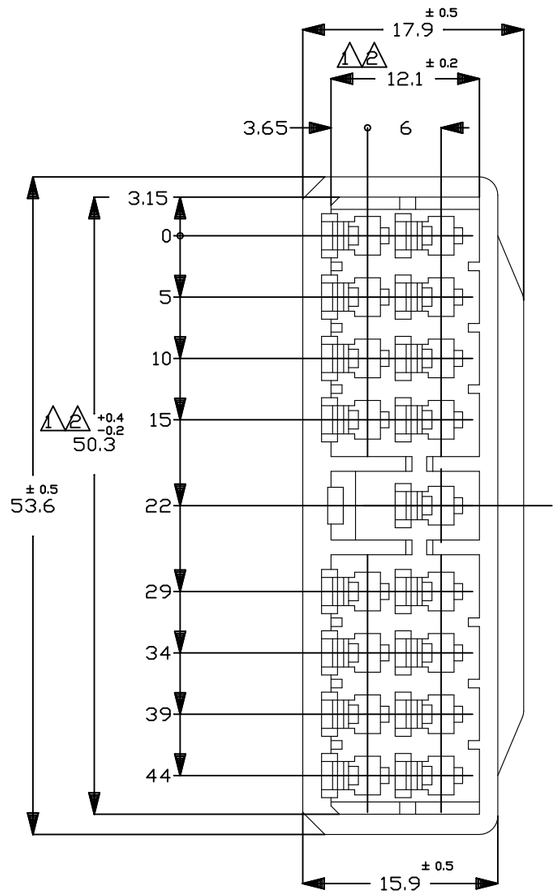

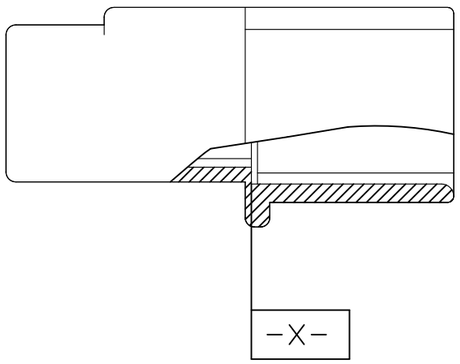

NOTES;

1. TO BE MEASURED WITH IN 2mm FROM -A-
2. IN COUPLING WITH THE PLUG HOUSING MATING SATISFIES FUNCTION
3. APPLIED CONTACT P/N 172777,172779
4. PRODUCT SPEC No. 108-5166
5. IN COUPLING WITH THE PLUG HOUSING MATING FORCE 29.4N〈3Kgf〉MAX. WITHOUT REC CONTACT

注；

1. -A- 面より2mmの範囲で測定
2. 相手ハウジングと所定の機能を満たして嵌合できること
3. 内装するタブコンタクト型番172777，172779他
4. 製品規格 NO.108-5166
5. 相手ハウジングとの嵌合力は3Kg以下
   但しタブコンタクトは含まない

OBSOLETE	~~172509-7~~	~~黄〈YELLOW〉~~
OBSOLETE	~~172509-6~~	~~灰〈GRAY〉~~
OBSOLETE	~~172509-5~~	~~青〈BLUE〉~~
	172509-4	緑〈GREEN〉
	172509-2	黒〈BLACK〉
	172509-1	自然色〈NATURAL〉
	番号〈PN〉	色〈COLOR〉

一般公差
〈GENERAL TOLERANCE〉
10以下： ±0.2
10を超え30以下： ±0.25
30を超え100以下： ±0.3
角 度 ±3°

THIS DRAWING IS A CONTROLLED DOCUMENT.

DIMENSIONS: mm

TOLERANCES UNLESS OTHERWISE SPECIFIED:
0 PLC ± –
1 PLC ± –
2 PLC ± –
3 PLC ± –
4 PLC ± –
ANGLES ± –

MATERIAL (NYLON)

FINISH –

DWN	K.YUASA	10/12'92
CHK	A.TOMITA	10/12'92
APVD	A.TOMITA	10/12'92
PRODUCT SPEC	—	
APPLICATION SPEC	—	
WEIGHT	—	

TE Connectivity

NAME
17 Pos. CAP HOUSING
MULTI-INTERLOCK CONN. (MIC-MK II)
–

SIZE	CAGE CODE	DRAWING NO	RESTRICTED TO
A3	00779	C-172509	—

CUSTOMER DRAWING

SCALE	SHEET	REV
2:1	1 OF 1	A1